

NOTES:

XXXXXXXXXXXXXXXXXXXXXXXXXXXX


XXXXXXXXXXXXXXXXXXXXXXXXXXXX

XXXXXXXXXXXXXXXXXXXXXXXXXXXX

XXXXXXXXXXXXXXXXXXXXXXXXXXXX

NOTES:

- * = MAINTAIN A MINIMUM OF 18 INCHES OF CLEARANCE BETWEEN OUTSIDE OF SEWER PIPE TO OUTSIDE OF WATER MAIN PIPE
- ** = MAINTAIN A MINIMUM OF 12 INCHES OF CLEARANCE BETWEEN EXISTING AND PROPOSED WATER MAINS.
- REFER TO SHEET XX FOR RESTORATION PLAN.

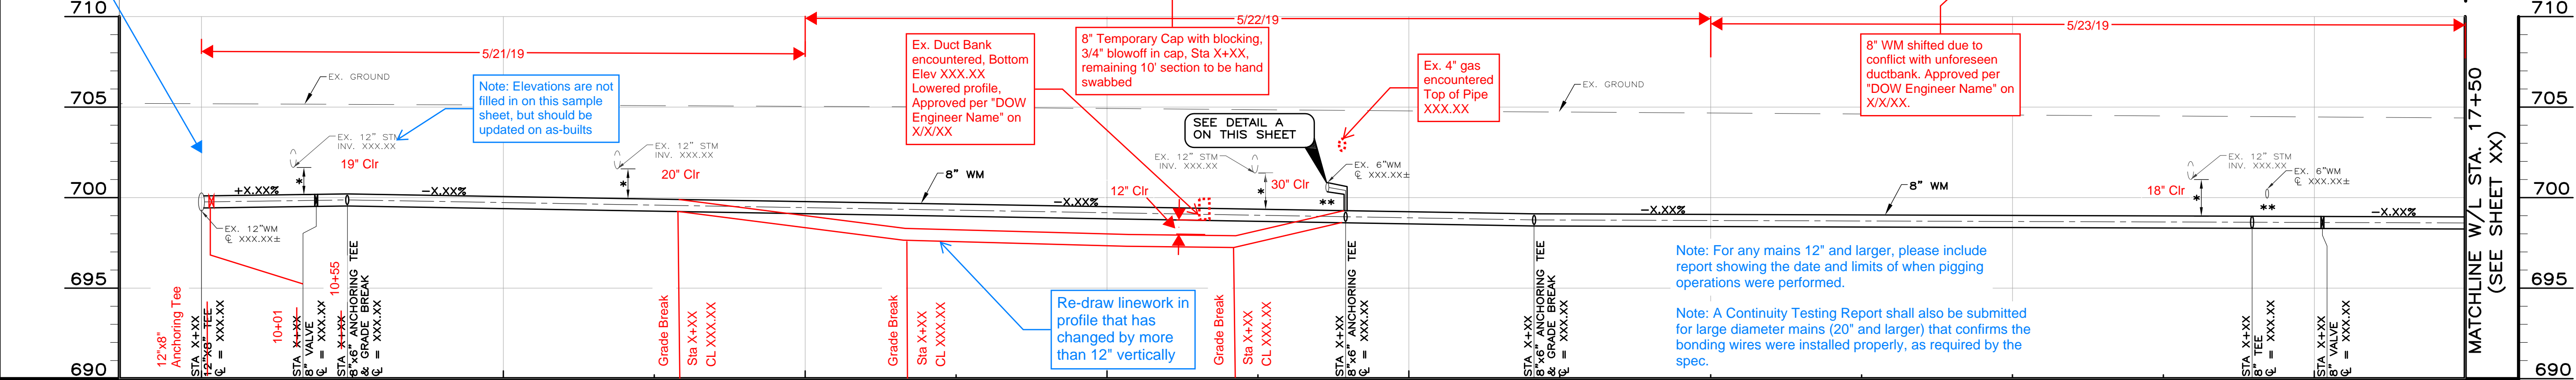

SPACE RESERVED FOR ENLARGED DETAIL

DETAIL A
 XXXXXXXXXXXXXXXXXXXXXXX
 STA XX+XX
 (HORIZ. SCALE 1"=10')
 (VERT. SCALE 1"=5')

WM STATION	10	11	12	13	14	15	16	17	WM STATION
GROUND	XXX.XX	XXX.XX	XXX.XX	XXX.XX	XXX.XX	XXX.XX	XXX.XX	XXX.XX	GROUND
C/L OF PIPE	XXX.XX	XXX.XX	XXX.XX	XXX.XX	XXX.XX	XXX.XX	XXX.XX	XXX.XX	C/L OF PIPE
CUT	XXX.XX	XXX.XX	XXX.XX	XXX.XX	XXX.XX	XXX.XX	XXX.XX	XXX.XX	CUT